
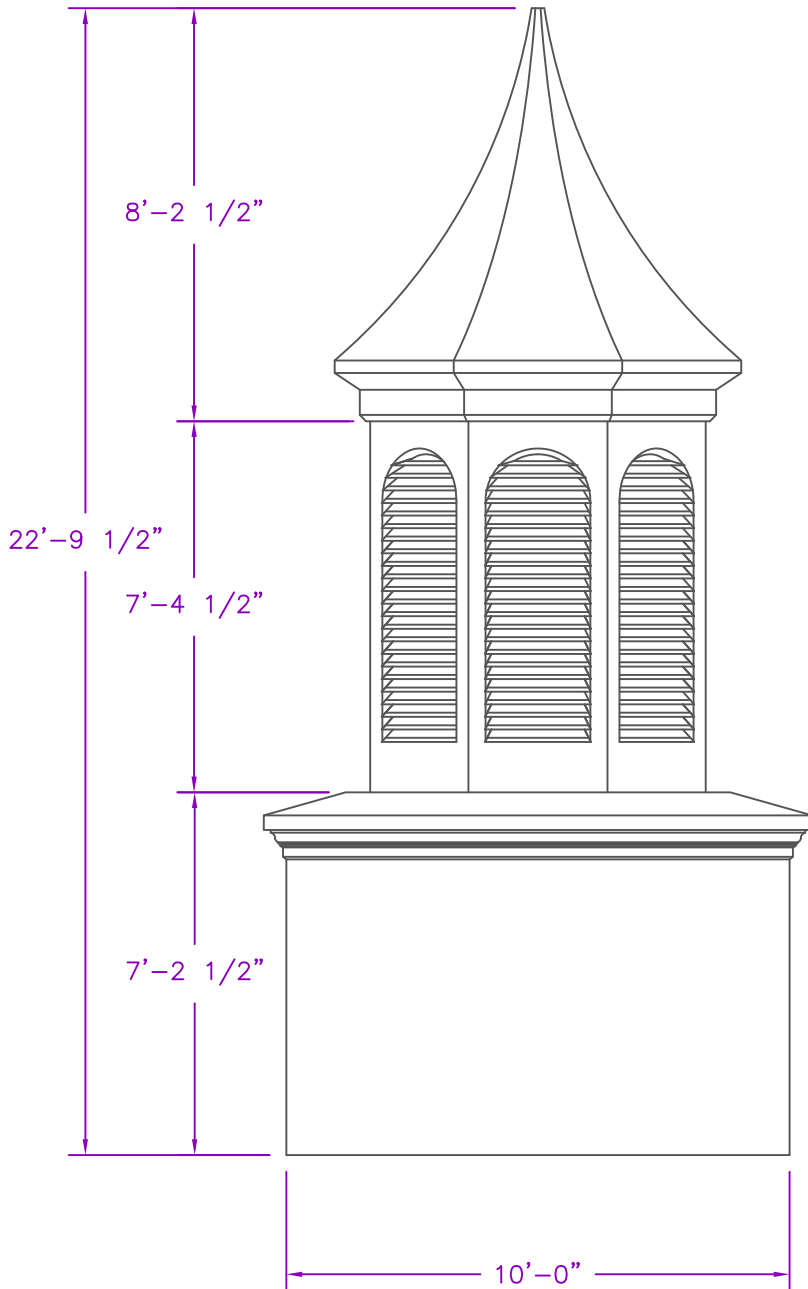


DESIGN PARAMETERS

The unit described in these drawings is engineered to adequately support the loads created by a wind velocity of 120 MPH at a height of 50' above ground using ASCE 7-95 exposure category "C". An additional 2' in height was added to the base during these calculations to account for variations in roof pitch, etc.

P.O. BOX 1340
 HENDERSON, TX 75653-1340
 903/657-6522
 FAX# 903/657-2318

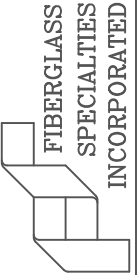

HAT UNIT #1050

CUPOLA UNIT #1050 WITH VENTED LOUVERS (ALSO AVAILABLE WITH KRINKLGLAS WINDOWS OR FALSE LOUVERS)

CUPOLA UNIT #705

12
 ? SPECIFY ROOF PITCH & TYPE

Project: CUPOLA UNIT #1109

Date: 09-05-00

Revisions AS BUILT CU705 7/13/05 TDR

Scale: 1/4" = 1'

Drawing By: RLB

Checked By:

File # ALL-STL

DWG # CU1109P

Sheet #

E1P

ELEVATION

THESE DRAWINGS ARE THE PROPERTY OF FIBERGLASS SPECIALTIES INC. DIMENSIONS AND DETAILS ARE SUBJECT TO CHANGE WITHOUT NOTICE. ALL CUPOLA AND STEEPLE UNITS ARE FABRICATED USING MINIMAL STANDING SEAMS UNLESS OTHERWISE NOTED. ALL CUPOLA AND STEEPLE UNITS ARE DESIGNED TO BE ERECTED ON A COMPLETED ROOFING SYSTEM AND ARE NOT GUARANTEED TO BE LEAK PROOF.